

No. 13-0103



JACKSONVILLE WASTEWATER UTILITY
248 Cloverdale Rd.
Jacksonville, AR 72076
501-982-0581

RESIDENTIAL OR COMMERCIAL BUILDING SEWER CONNECTION PERMIT

Street Address 1018 Wooten Rd

Legal Description _____

Facility to be connected to sewer:

Single Family Residence ☒ *Multi-family Residential _____ Units _____

*Commercial Installation _____ Description: New Connection

Water Meter (s) Size _____

* Commercial installations, and multi-family installations of more than 4 dwelling units must be accompanied by a site plan showing the proposed building sewer.

Sewer line installation by Ables Plumbing 870 798 3900


Address 2950 Calhoun 182 Hampton, AR 71744

General Co 1018 WOOTEN RD

Address 130ft sch 40-4"

In consider 24920 1/2" 3578

1. To access _____
2. To main public sewer M/H 3578
3. To notify to the public ⊗

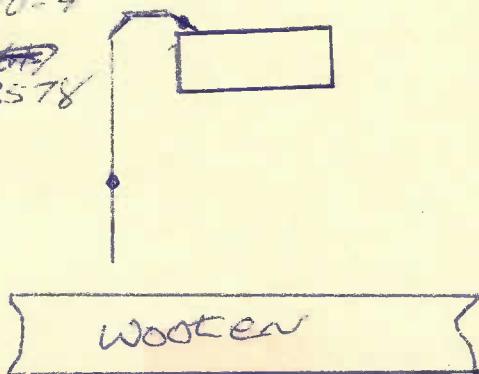

Fees: Co _____

Tap Charge \$ _____ Receipt No. _____

Inspection Fee \$ 0 Receipt No. N/C

Street Cut \$ _____ Receipt No. _____

APPLICANT Signed [Signature]

- ☐ Plumbing Contractor
☐ General Contract
☐ Owner (Address _____)

Mark up

APPROVED Jacksonville Wastewater Utility

By: Jessica Kendrick Date: 4/1/13

Complete 6/6/13