



No. 12-0132

JACKSONVILLE WASTEWATER UTILITY
248 Cloverdale Rd.
Jacksonville, AR 72076
501-982-0581

RESIDENTIAL OR COMMERCIAL BUILDING SEWER CONNECTION PERMIT

Street Address 405 Warren Street

Legal Description _____

Facility to be connected to sewer:

Single Family Residence ☒ *Multi-family Residential _____ Units SLD

*Commercial Installation _____ Description: Replacema

Water Meter (s) Size 5/8"

* Commercial installations, and multi-family installations of more than 4 dwelling units must be accompanied by a site plan showing the proposed building sewer.

Sewer line installation by A. K. Plumber 918 5788

Address 405 Warren St

General Con 113 ft 4" sch 40

Address 0 ft to m/h #

In considerat Ties to m/h


1. To accept
2. To mainta public sev
3. To notify 1 to the put

Fees: Con 405 Warren St
Tap 113 ft sch 40-4"
Insp 236 ft to m/h # 956

Stre _____

APPLICANT Signed _____

- ☐ F
- ☐ C
- ☐ C

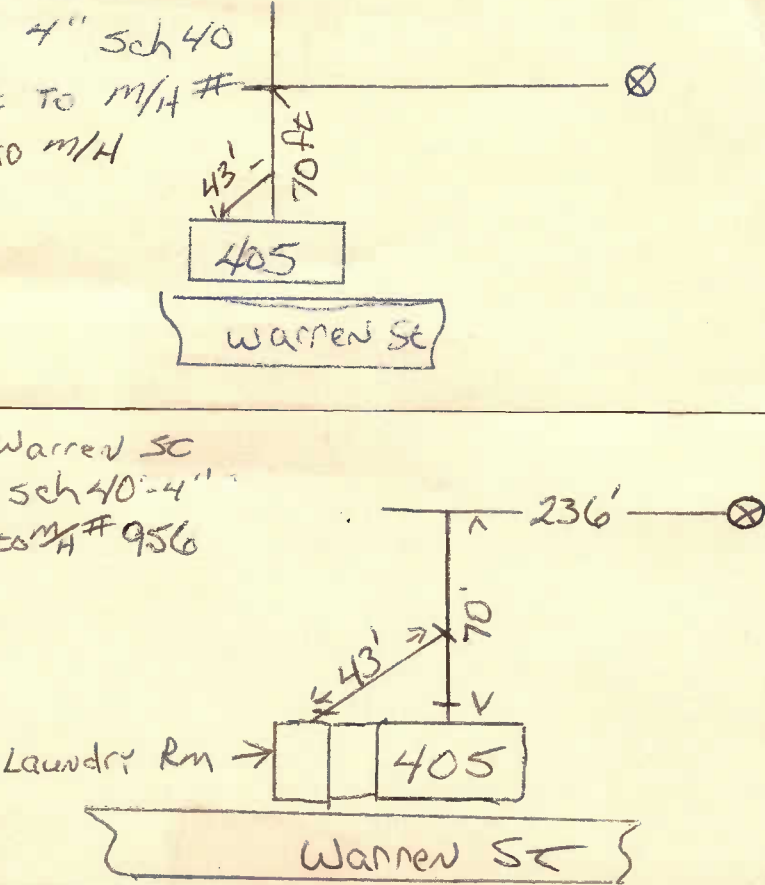

APPROVED
Jacksonville Wastewater Utility

By: [Signature] Date: 9/25/12