



# JACKSONVILLE WASTEWATER UTILITY

248 Cloverdale Rd.  
Jacksonville, AR 72076  
501-982-0581

No. 13-0018

## RESIDENTIAL OR COMMERCIAL BUILDING SEWER CONNECTION PERMIT

Street Address 4602 B5 Letter Park Loop

Legal Description \_\_\_\_\_

Facility to be connected to sewer:

Single Family Residence ☒ \*Multi-family Residential \_\_\_\_\_ Units \_\_\_\_\_

\*Commercial Installation \_\_\_\_\_ Description: New Connection

Water Meter (s) Size 5/8"

\* Commercial installations, and multi-family installations of more than 4 dwelling units must be accompanied by a site plan showing the proposed building sewer.

Sewer line installation by \_\_\_\_\_

Address 4602 Letter Park Loop Apt 35

General 200' sch 40-4"


Address Ties to M 43608

In cons \_\_\_\_\_

1. To a \_\_\_\_\_

2. To n  
publ \_\_\_\_\_

3. To n  
to th \_\_\_\_\_

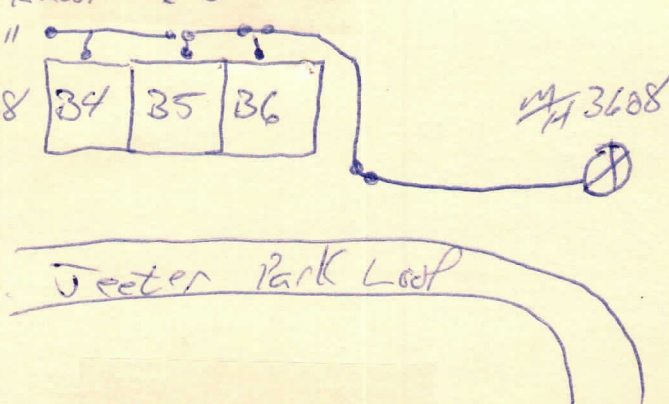

Fees: Connection Fee \$ 75.00

Receipt No. 750050 1/25/13

Tap Charge \$ \_\_\_\_\_

Receipt No. Returned

Inspection Fee \$ 25.00

Receipt No. 750050 1/25/13

Street Cut \$ \_\_\_\_\_

Receipt No. \_\_\_\_\_

APPLICANT

Signed Traverse Atkins

☐ Plumbing Contractor

☐ General Contract

☐ Owner (Address Traverse Atkins - owner  
501 607-1493)

10/14/13  
Complete

APPROVED

Jacksonville Wastewater Utility

By: Jessica Kende Date: 2/8/13