



JACKSONVILLE WASTEWATER UTILITY

248 Cloverdale Rd.
Jacksonville, AR 72076
501-982-0581

No. 13-0019

RESIDENTIAL OR COMMERCIAL BUILDING SEWER CONNECTION PERMIT

Street Address 4602 BL Jetter Park Loop

Legal Description _____

Facility to be connected to sewer:

Single Family Residence ☒ *Multi-family Residential _____ Units _____

*Commercial Installation _____ Description: New Connection

Water Meter (s) Size 5/8"

* Commercial installations, and multi-family installations of more than 4 dwelling units must be accompanied by a site plan showing the proposed building sewer.

Sewer line installation by _____

Address 4602 Jetter PK Loop (B6)

General C 260 ft sch 40-4"


Address ties to #A 3608

In consid

1. To acc

2. To ma
public

3. To no
to the

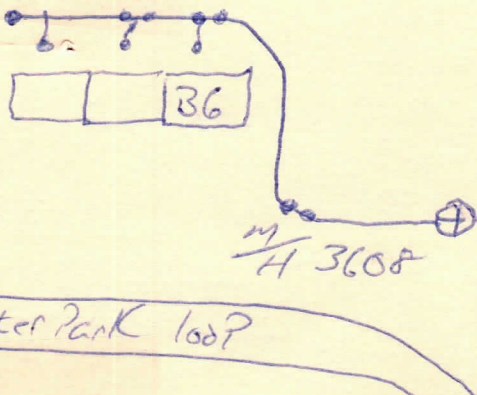

Fees: Connection Fee

\$ ~~75.00~~

Receipt No. N/C 750050

Tap Charge

\$ _____

Receipt No. _____

Inspection Fee

\$ ~~25.00~~

Receipt No. N/C 750050

Street Cut

\$ _____

Receipt No. _____

APPLICANT

Signed Traverse Atkins

☐ Plumbing Contractor

☐ General Contract

☒ Owner (Address Traverse Atkins - owner)

501-607-1493

completed
10/19/13

APPROVED

Jacksonville Wastewater Utility

By: Jessica Kendrick

Date: 2/8/13