



JACKSONVILLE WASTEWATER UTILITY
248 Cloverdale Rd.
Jacksonville, AR 72076
501-982-0581

No. 13-0154

RESIDENTIAL OR COMMERCIAL BUILDING SEWER CONNECTION PERMIT

Street Address 8313 Hwy 161

Legal Description _____

Facility to be connected to sewer:

Single Family Residence ☒ *Multi-family Residential _____ Units _____

*Commercial Installation _____ Description: New Connection

Water Meter (s) Size _____

* Commercial installations, and multi-family installations of more than 4 dwelling units must be accompanied by a site plan showing the proposed building sewer.

Sewer line installation by Ables Plumbing 870 798 3900

Address 8313 Hwy 161

General C 228 ft sch 40-4"


Address Ties to M/H 3565

In consid _____

1. To acc _____

2. To ma public _____

3. To not to the _____

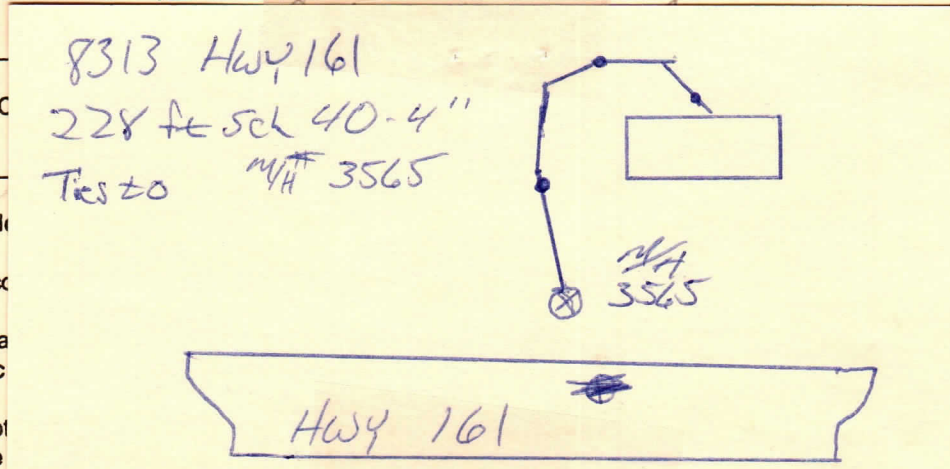

Fees: Connection Fee \$ 0 Receipt No. MC

Tap Charge \$ _____ Receipt No. _____

Inspection Fee \$ 0 Receipt No. MC

Street Cut \$ _____ Receipt No. _____

APPLICANT Signed [Signature]

- ☐ Plumbing Contractor
☐ General Contract
☐ Owner (Address _____)

Mark
6-17

Complete
6/17/13
E

APPROVED
Jacksonville Wastewater Utility

By: Jessica Kendrick Date: 6/6/13