



No. 93- 034

JACKSONVILLE WASTEWATER UTILITY

248 Cloverdale Road · P.O. Box 69
Jacksonville, AR 72076
982-0581

RESIDENTIAL OR COMMERCIAL BUILDING SEWER CONNECTION PERMIT

Street Address 401 N. 4th

Legal Description _____

Facility to be connected to sewer:


Single Family Residence _____ *Multi-family Residential _____ Units _____

*Commercial Installation ☒ Description: Replacement

Water Meter (s) Size 5/8"

* Commercial installations, and multi-family installations of more than 4 dwelling units must be accompanied by a site plan showing the proposed building sewer.

Sewer line installation by AAA

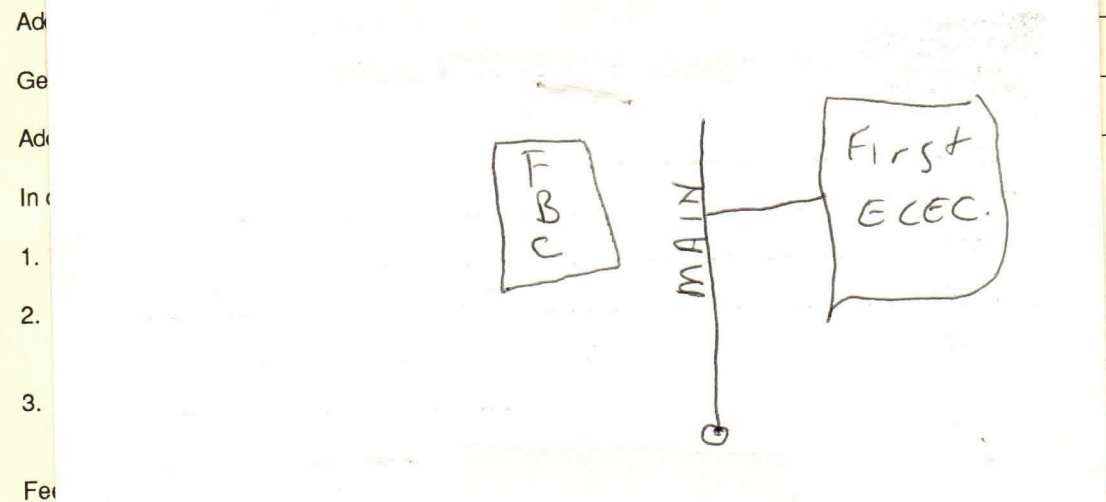

Tap Charge \$ _____

Receipt No. _____

Inspection Fee \$ 6.00

Receipt No. 1410 4/30

Total Fees \$ _____

APPLICANT

Signed [Signature]

☒ Plumbing Contractor

☐ General Contract

☐ Owner (Address _____)

APPROVED

Jacksonville Wastewater Utility

By: [Signature] Date: 4/30/13



No. 990474

JACKSONVILLE WASTEWATER UTILITY248 Cloverdale Road • P.O. Box 69
Jacksonville, AR 72078-0069
982-0581**RESIDENTIAL OR COMMERCIAL BUILDING SEWER CONNECTION PERMIT**Street Address 901 North First StreetLegal Description First Electric Coop

Facility to be connected to sewer:

Single Family Residence _____ *Multi-family Residential _____ Units _____

*Commercial Installation ☒ Description: Repair

Water Meter (s) Size _____

* Commercial installations, and multi-family installations of more than 4 dwelling units must be accompanied by a site plan showing the proposed building sewer.

Sewer line installation by Doyle Hunter First Elect.

Add

Ger

Add


In c

1.

2.

3.

t

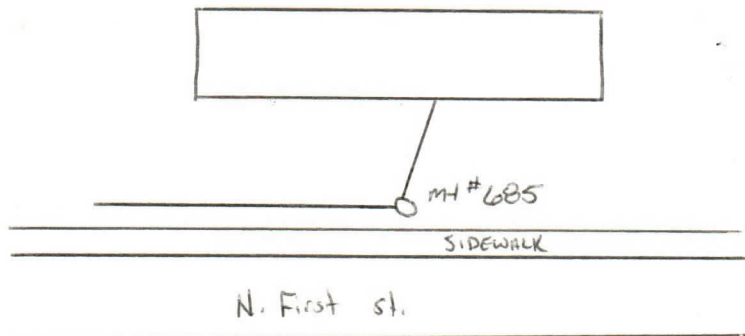

\$ _____

Receipt No. _____

\$ 6.00Receipt No. 9478

\$ _____

Doyle HunterContractor
Contract
Address _____

r Utility

CanoeDate: 10/21/99

Doyle Hunter, Maintenance

First Electric
Cooperative Corporation901 North First Street
P.O. Box 5018
Jacksonville, Arkansas 72078
Jacksonville Phone: (501) 982-4545
Toll Free: 1-800-489-7405
Fax: (501) 982-8450



JACKSONVILLE WASTEWATER UTILITY

248 Cloverdale Rd.
Jacksonville, AR 72076
501-982-0581

No. 13-0006

RESIDENTIAL OR COMMERCIAL BUILDING SEWER CONNECTION PERMIT

Street Address 901 N. 1st St

Legal Description _____

Facility to be connected to sewer:

Single Family Residence ☒ *Multi-family Residential _____ Units _____

*Commercial Installation _____ Description: Replacement

Water Meter (s) Size 5/8

* Commercial installations, and multi-family installations of more than 4 dwelling units must be accompanied by a site plan showing the proposed building sewer.

Sewer line installation by Plumb-Pro - person 838-6912

Address 901 1st Street
50 ft of Sch 40

General Ties to MH # 03-0104


Address _____

In cons _____

1. To _____

2. To _____
pub _____

3. To _____
to th _____

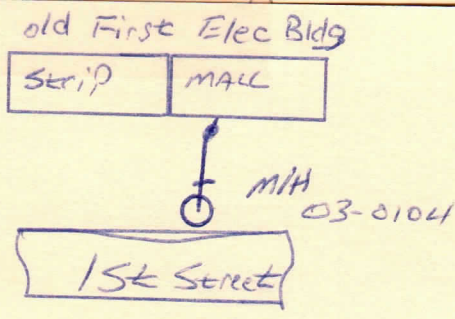

Fees: Connection Fee \$ _____ Receipt No. _____

Tap Charge \$ _____ Receipt No. _____

Inspection Fee \$ 25.00 Receipt No. 750013

Street Cut \$ _____ Receipt No. _____

APPLICANT Signed [Signature]

- ☒ Plumbing Contractor
- ☐ General Contract
- ☐ Owner (Address _____)

APPROVED Jacksonville Wastewater Utility

By: [Signature] Date: 1/11/13

Complete
1/14/13